


TAKPLAN

1:100

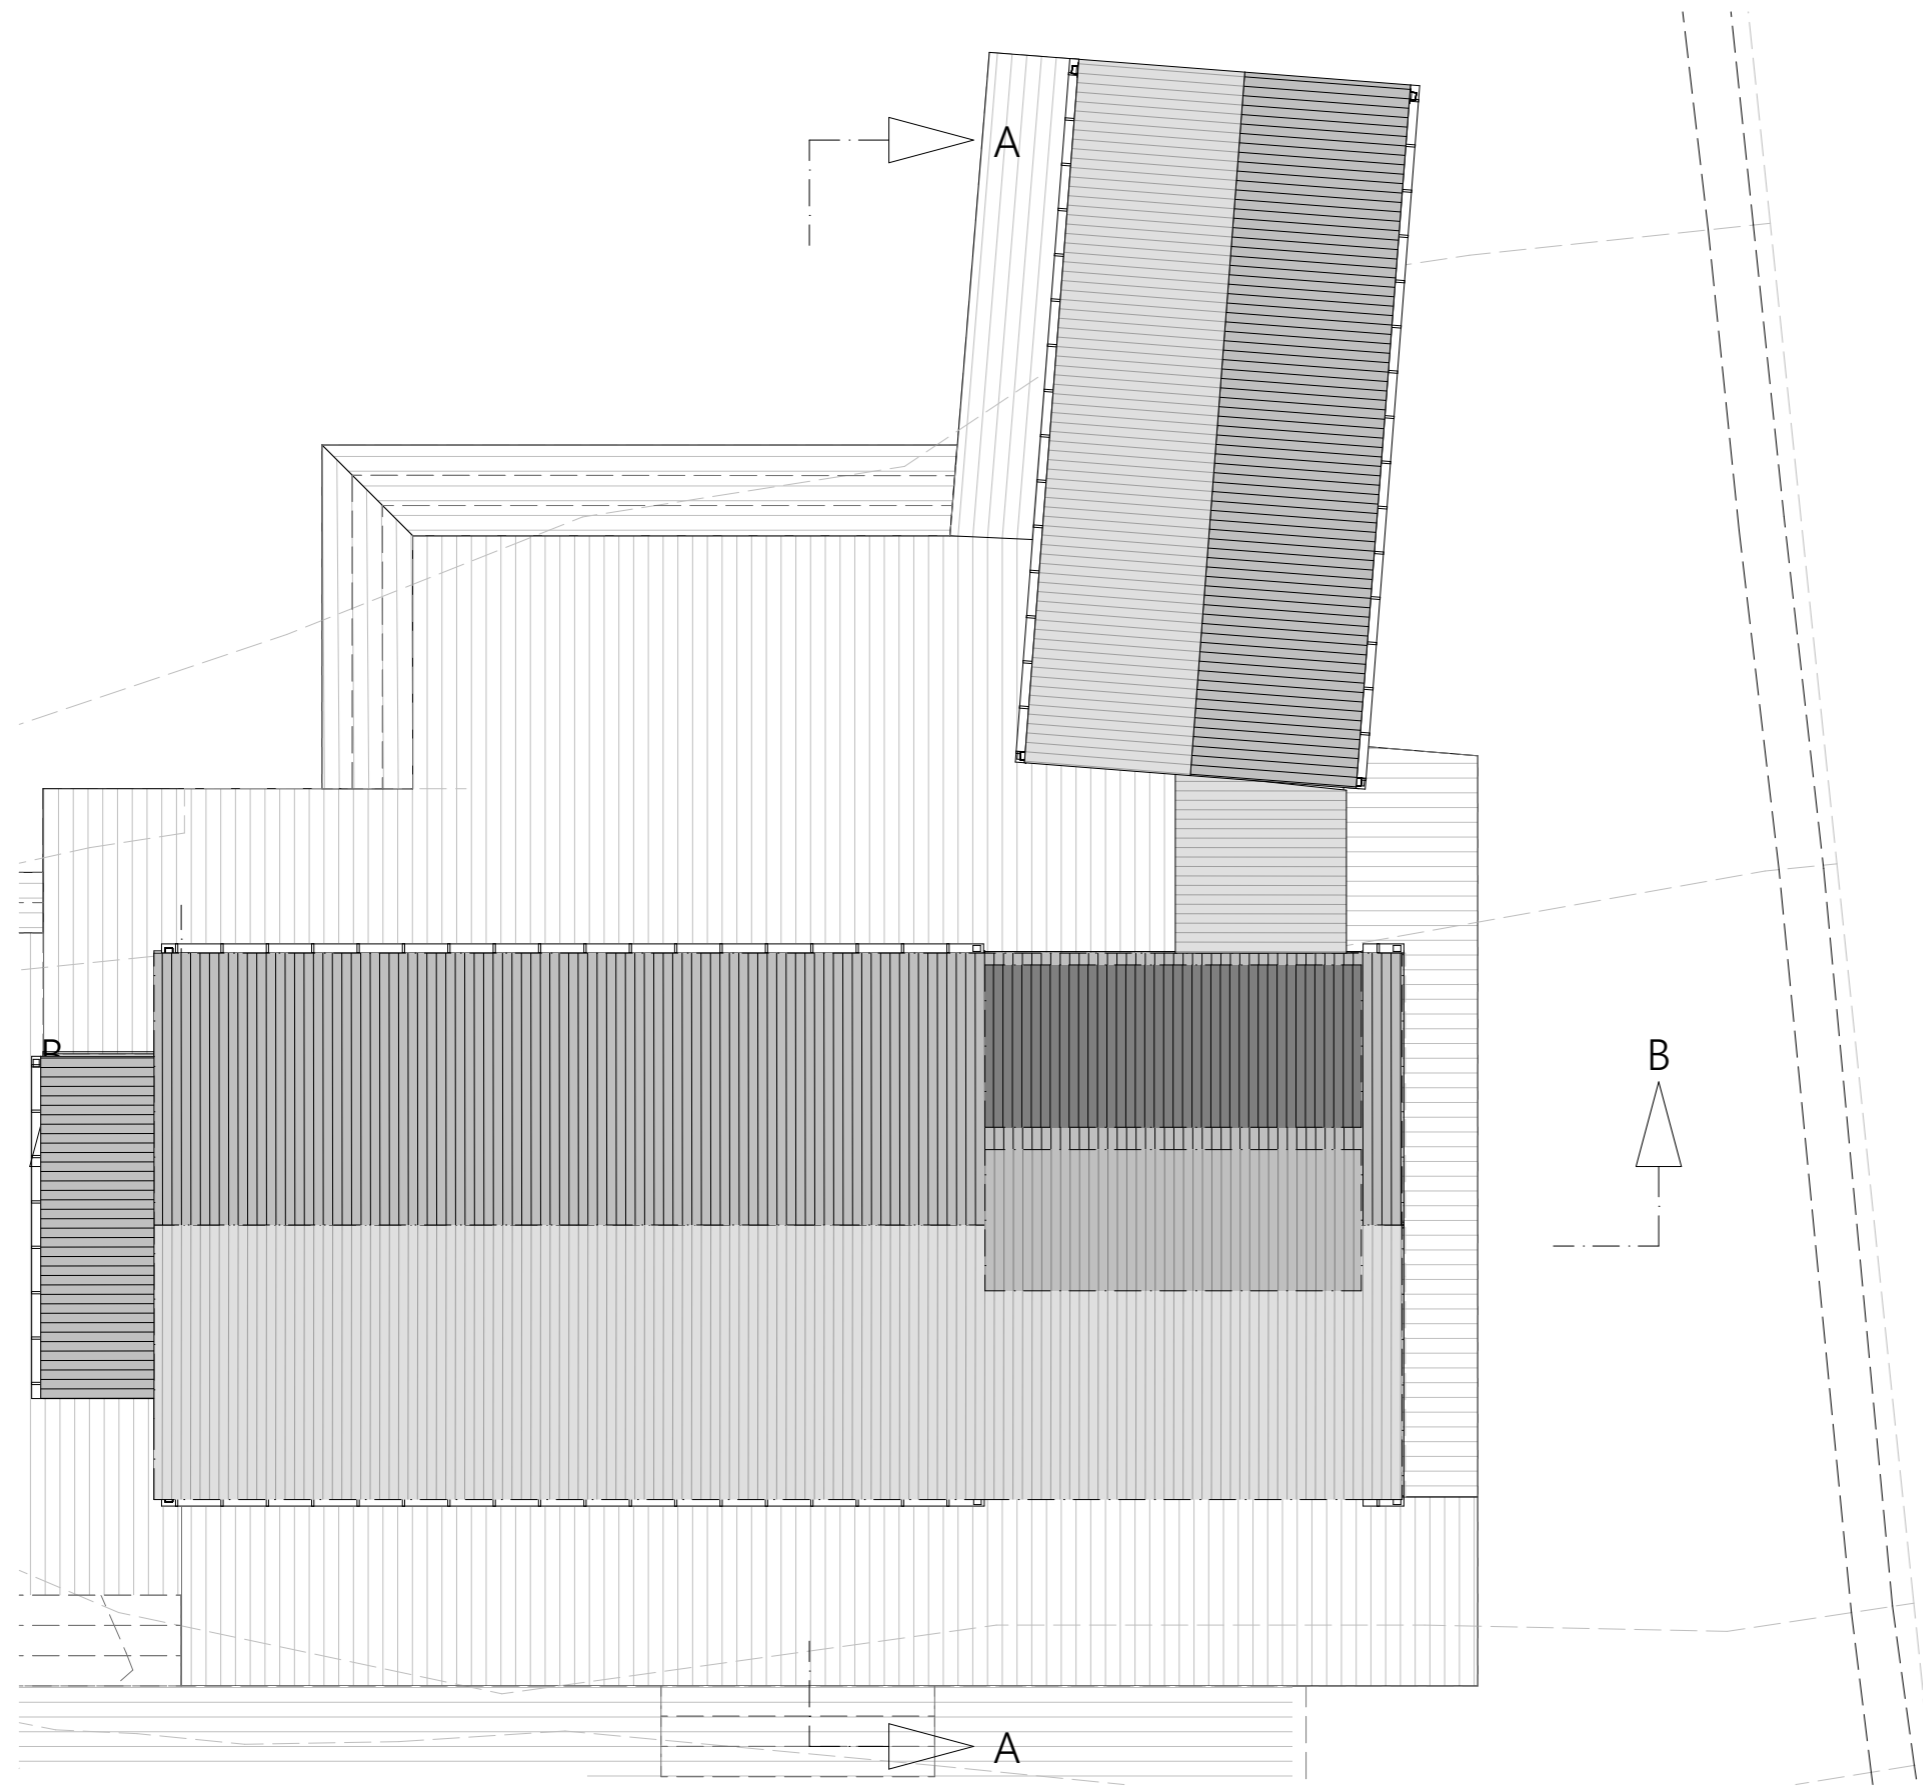

SKALA 1:100



RELATIONSHANDLING

BRATT
lifestyle architecture

VIKDALSVÄGEN 50 131 52 NACKA STRAND, SWEDEN PH:+46 8 556 150 75

FOGDÖ 3:48
KOLSKÄRET 39
764 57 GRISSLEHAMN

RITAD
CG B

TAKPLAN

STOCKHOLM:
2021-03-05

RITNINGNUMMER
A 30:03

SKALA